


LEGEND												
EQUIPMENT	MK	TAG	QTY	DESCRIPTION	MFG.	MOD.	MK	TAG	QTY	DESCRIPTION	MFG.	MOD.
	A	F-1100	1	BASKET STRAINER: 4" 150# FF	VIKING	F1040-FIRN-021	F	P-1000	1	SAMPLE PUMP: 1 1/4" SUCTION, 1" DISCHARGE	FLOWSERVE	SMP-1000
	B	P-1100	1	CHARGE PUMP: 3" 150# FF SUCTION, 2" 150# FF DISCHARGE	FLOWSERVE	2K3x2-13RV-DCI	G	H-1000 H-1100		MOTOR: 1/2 HP, 1800 RPM, 120-230V/1/60, XP	-	-
			1	MOTOR: 15 HP, 1800 RPM, 480/3/60, CLASS I, DIV. I, GRP. D	-	184T FRAME			HEATER: 3.6kW 480/1	CCI THERMAL	RADIANT STYLE	
	C	F-1101	1	BASKET STRAINER: 3" 150# FF, W/ ARMSTRONG 11AV AIR ELIM.	VIKING	F1030-FIRN-021						
	D	LM-1100	1	LIQUID METER: MICRO MOTION, 3" 150# RF, w/	MICRO MOTION	CMF300M	H	B-1000	1	EXHAUST FAN: 12" W/ 1/4 HP, 1725 RPM, 115/1/60, XP MOTOR	DAYTON	3XK51
			1	FLOW & DENSITY TRANSMITTER	MICRO MOTION	MVD2700	I		1	FIBERGLASS BUILDING: 12' x 16' x 8'-9" PEAK, GABLE STYLE	-	-
	E	V-1000	1	SAMPLE TANK: 14" S/40 x 2'-0" S/S, WELD CAP, AND SEALED TANK LID,	PSI	14-2-VST-30-D	J		1	STRUCTURAL STEEL SKID: 12' x 23'-2 1/4" x 0'-8 3/8"	PSI	-
				INTERNAL COATING, & 5/8" x 20" SIGHT GLASS W/ 4-BAR PROTECTION								

SWO # LOG	
SWO#1	1088858 (REF. HSCP-LACT-7)
SWO#2	1088873 x8
SWO#3	
SWO#4	
SWO#5	

REVISED	
PREPARED BY:	CLC
DATE:	04/15/13
REVISION #	3
APPROVED BY:	ZR
SWO #	SEE LOG

SEE NOTE 6

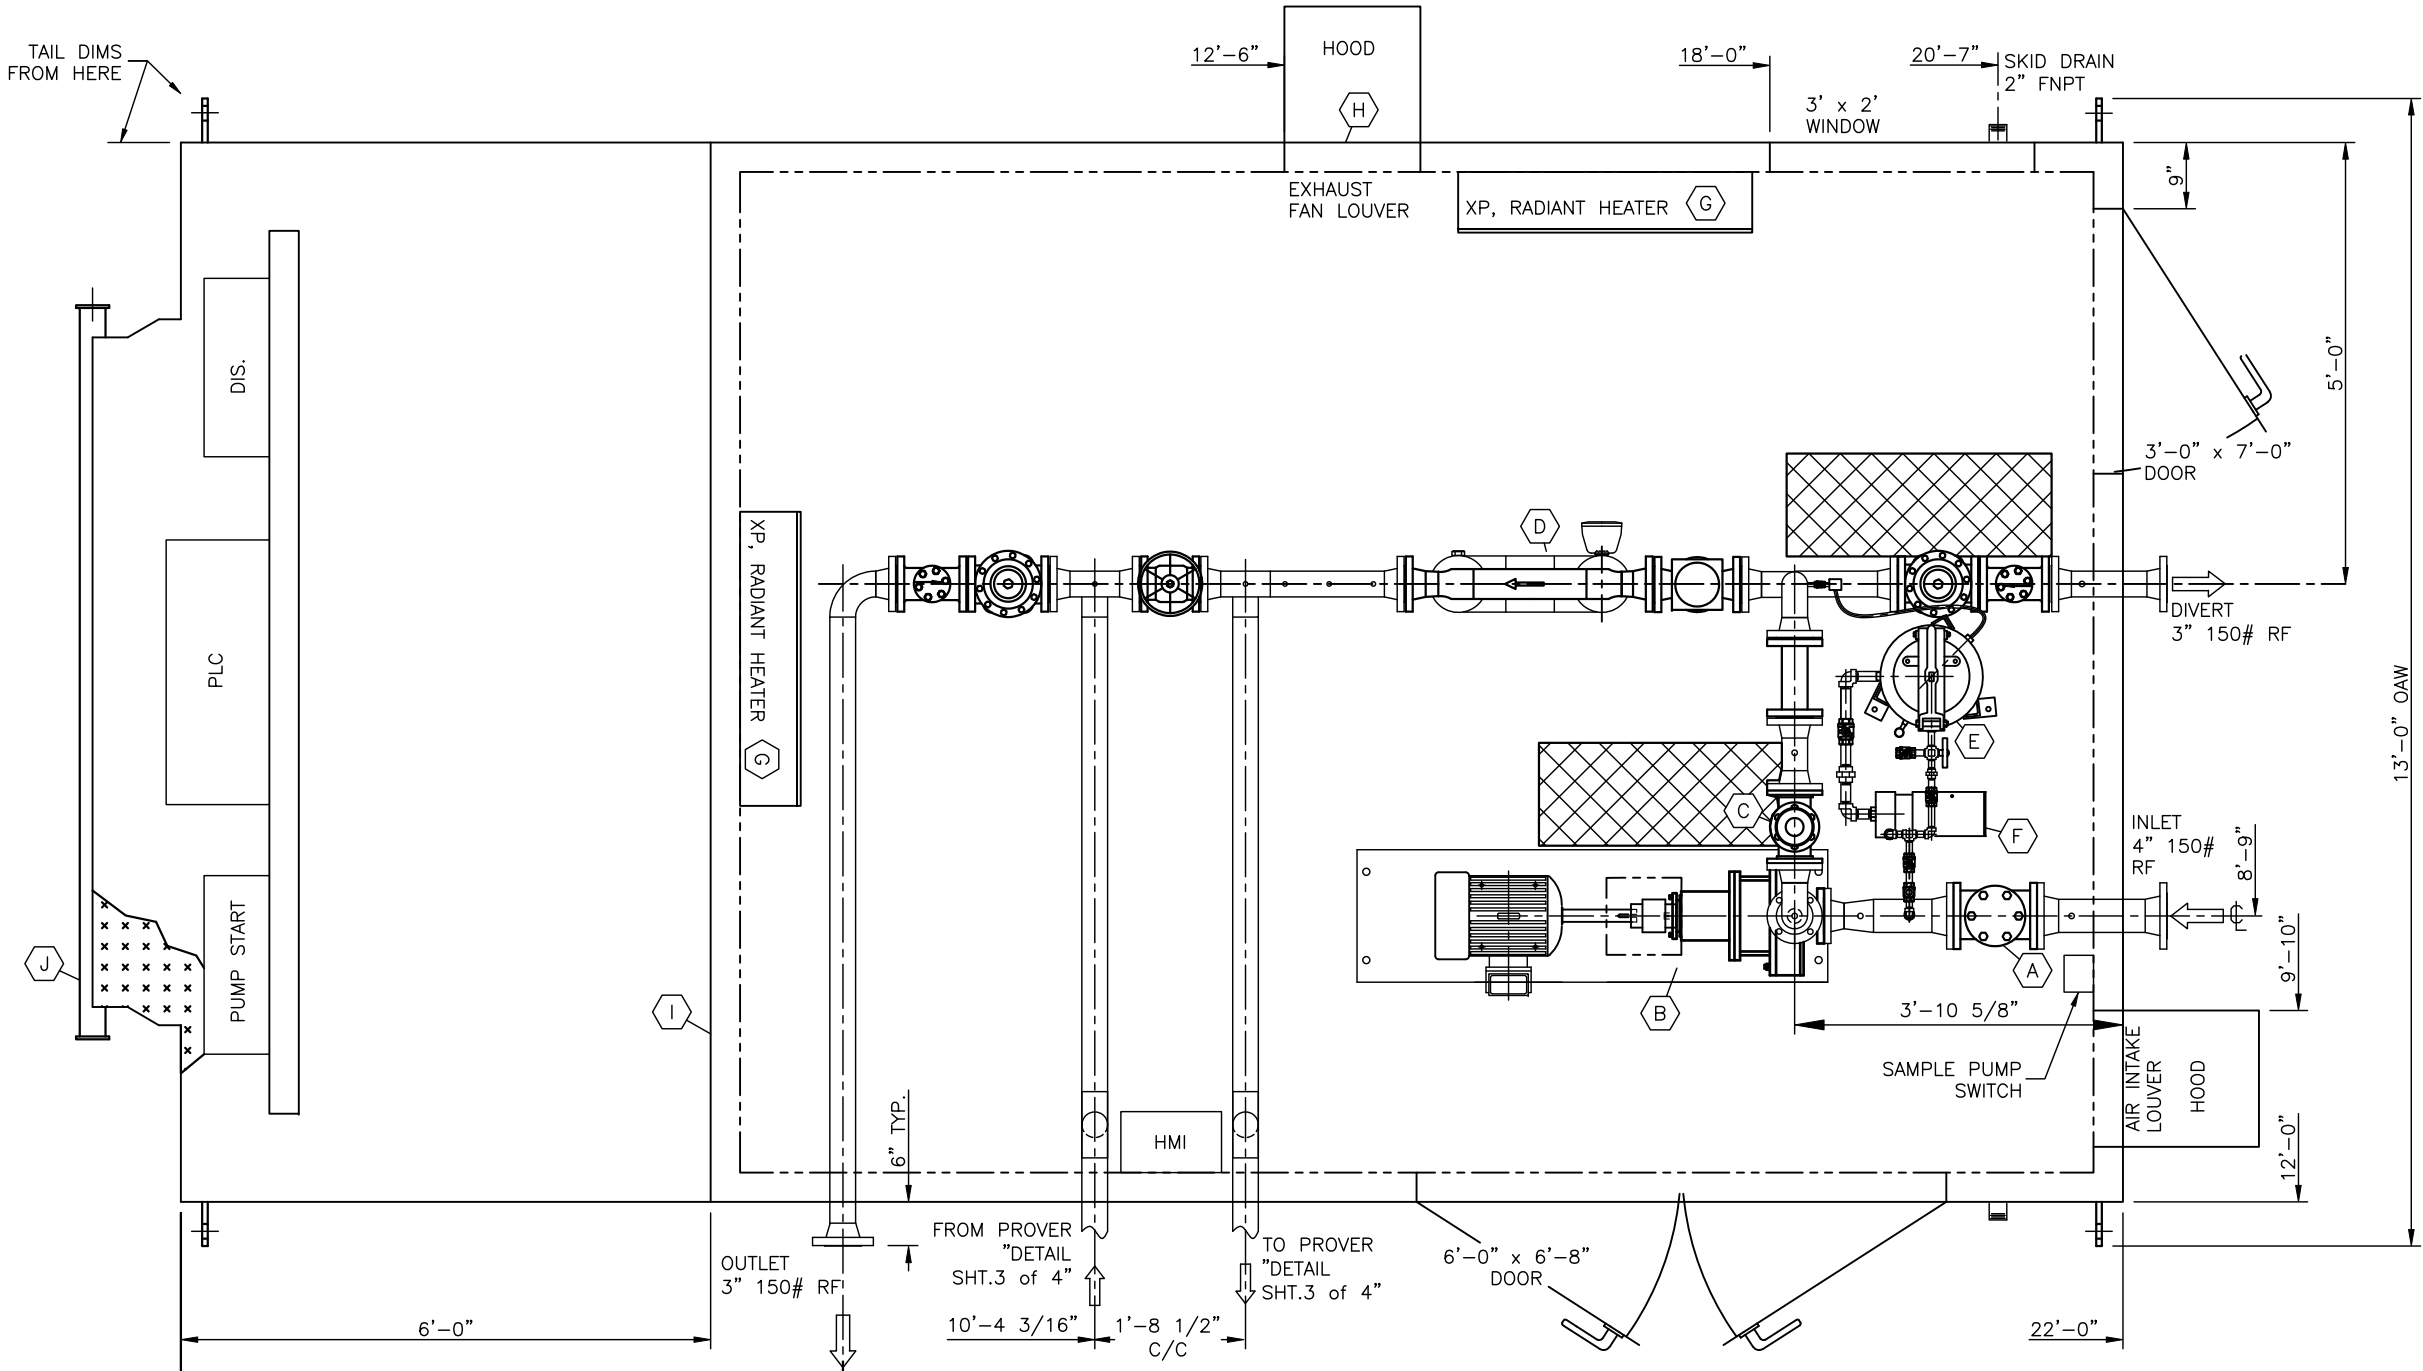

PLAN

NOTES:

1. REF. SHT.4 "SAMPLE DIAGRAM" FOR PIPING REFERENCE.
2. TOTAL PKG. WEIGHT APPROX. 11,500 LBS.
3. INTERIOR BUILDING COLOR: WHITE
4. EXTERIOR BUILDING, SKID, AND DECKPLATE COLOR: CARLSBAD CANYON TAN
5. INSULATION TO BE: R-13 & 2" SPRAY FOAM UNDER SKID.
6. SO1088858 REDESIGN TO DWG# HSCP-LACT-7 SET OF DRAWINGS: P-1100 & LM-1100 CHANGE & NO DIVERT

NOTICE: This drawing has not been published but rather has been prepared for

by Power Service solely in respect of the construction, operation, and maintenance of the facility named in the title block and shall not be used for any other purpose or furnished to any other party, without the express written consent of Power Service, Inc.

NO.	DATE	BY	DESCRIPTION	CHK'D	APPR.	DWG NO.	TITLE
3	04/15/13	CLC	AS-BUILT	ZR	SK		
2	09/05/12	JS	ADD 3070 DOOR, LOWERED PROVING LINES	ZR	SK		
1	08/20/12	JS	AS BUILT MARKUPS	ZR	SK		
0	06/18/12	JS	FOR CONSTRUCTION	ZR	SK		
A	05/25/12	JE	FOR APPROVAL	ZR	SK	HSCP-LACT-PID-6	P&ID
REVISIONS							
REFERENCE DRAWINGS							

**PS** POWER SERVICE, INC.  
CASPER, WYOMING USA  
(307) 472-7722

THIS DRAWING IS THE PROPERTY OF POWER SERVICE CASPER, WYOMING, USA.

CUSTOMER

EQUIPMENT GENERAL ARRANGEMENT  
SWEET CRUDE LACT/LINE PUMP PKG.  
C.O.S. 80°F, .82 SG, 8,400 BPD @ 45 PSI


DWN BY	CHK'D BY	APP'D BY	ENGINEER	DATE DWN	SCALE	SHEET	PROJECT NO.	DWG. NO.	REV.
JE	ZR	SK	-	05/25/12	N.T.S.	1 OF 4	SEE-LOG	D-HSCP-LACT-L0-6	3

LEGEND												
EQUIPMENT	MK	TAG	QTY	DESCRIPTION	MFG.	MOD.	MK	TAG	QTY	DESCRIPTION	MFG.	MOD.
	A	F-1100	1	BASKET STRAINER: 4" 150# FF	VIKING	F1040-FIRN-021	F	P-1000	1	SAMPLE PUMP: 1 1/4" SUCTION, 1" DISCHARGE	FLOWERVE	SMP-1000
	B	P-1100	1	CHARGE PUMP: 3" 150# FF SUCTION, 2" 150# FF DISCHARGE	FLOWERVE	2K3x2-13RV-DCI	F			MOTOR: 1/2 HP, 1800 RPM, 120-230V/1/60, XP	-	-
			1	MOTOR: 15 HP, 1800 RPM, 480/3/60, CLASS I, DIV. I, GRP. D	-	184T FRAME	G	H-1000	2	HEATER: 3.6kW 480/1	CCI THERMAL	RADIANT STYLE
	C	F-1101	1	BASKET STRAINER: 3" 150# FF, W/ ARMSTRONG 11AV AIR ELIM.	VIKING	F1030-FIRN-021	H	H-1100				
	D	LM-1100	1	LIQUID METER: MICRO MOTION, 3" 150# RF, w/	MICRO MOTION	CMF300M	H	B-1000	1	EXHAUST FAN: 12" W/ 1/4 HP, 1725 RPM, 115/1/60, XP MOTOR	DAYTON	3XK51
			1	FLOW & DENSITY TRANSMITTER	MICRO MOTION	MVD2700	I		1	FIBERGLASS BUILDING: 12' x 16' x 8'-9" PEAK, GABLE STYLE	-	-
	E	V-1000	1	SAMPLE TANK: 14" S/40 x 2'-0" S/S, WELD CAP, AND SEALED TANK LID,	PSI	14-2-VST-30-D	J		1	STRUCTURAL STEEL SKID: 12' x 23'-2 1/4" x 0'-8 3/8"	PSI	-
				INTERNAL COATING, & 5/8" x 20" SIGHT GLASS W/ 4-BAR PROTECTION								

SWO # LOG	
SWO#1	1088858 (REF. HSCP-LACT-7)
SWO#2	1088873 x8
SWO#3	
SWO#4	
SWO#5	

REVISED	
PREPARED BY:	CLC
DATE:	04/15/13
REVISION #	3
APPROVED BY:	ZR
SWO #	SEE LOG

SEE NOTE 6

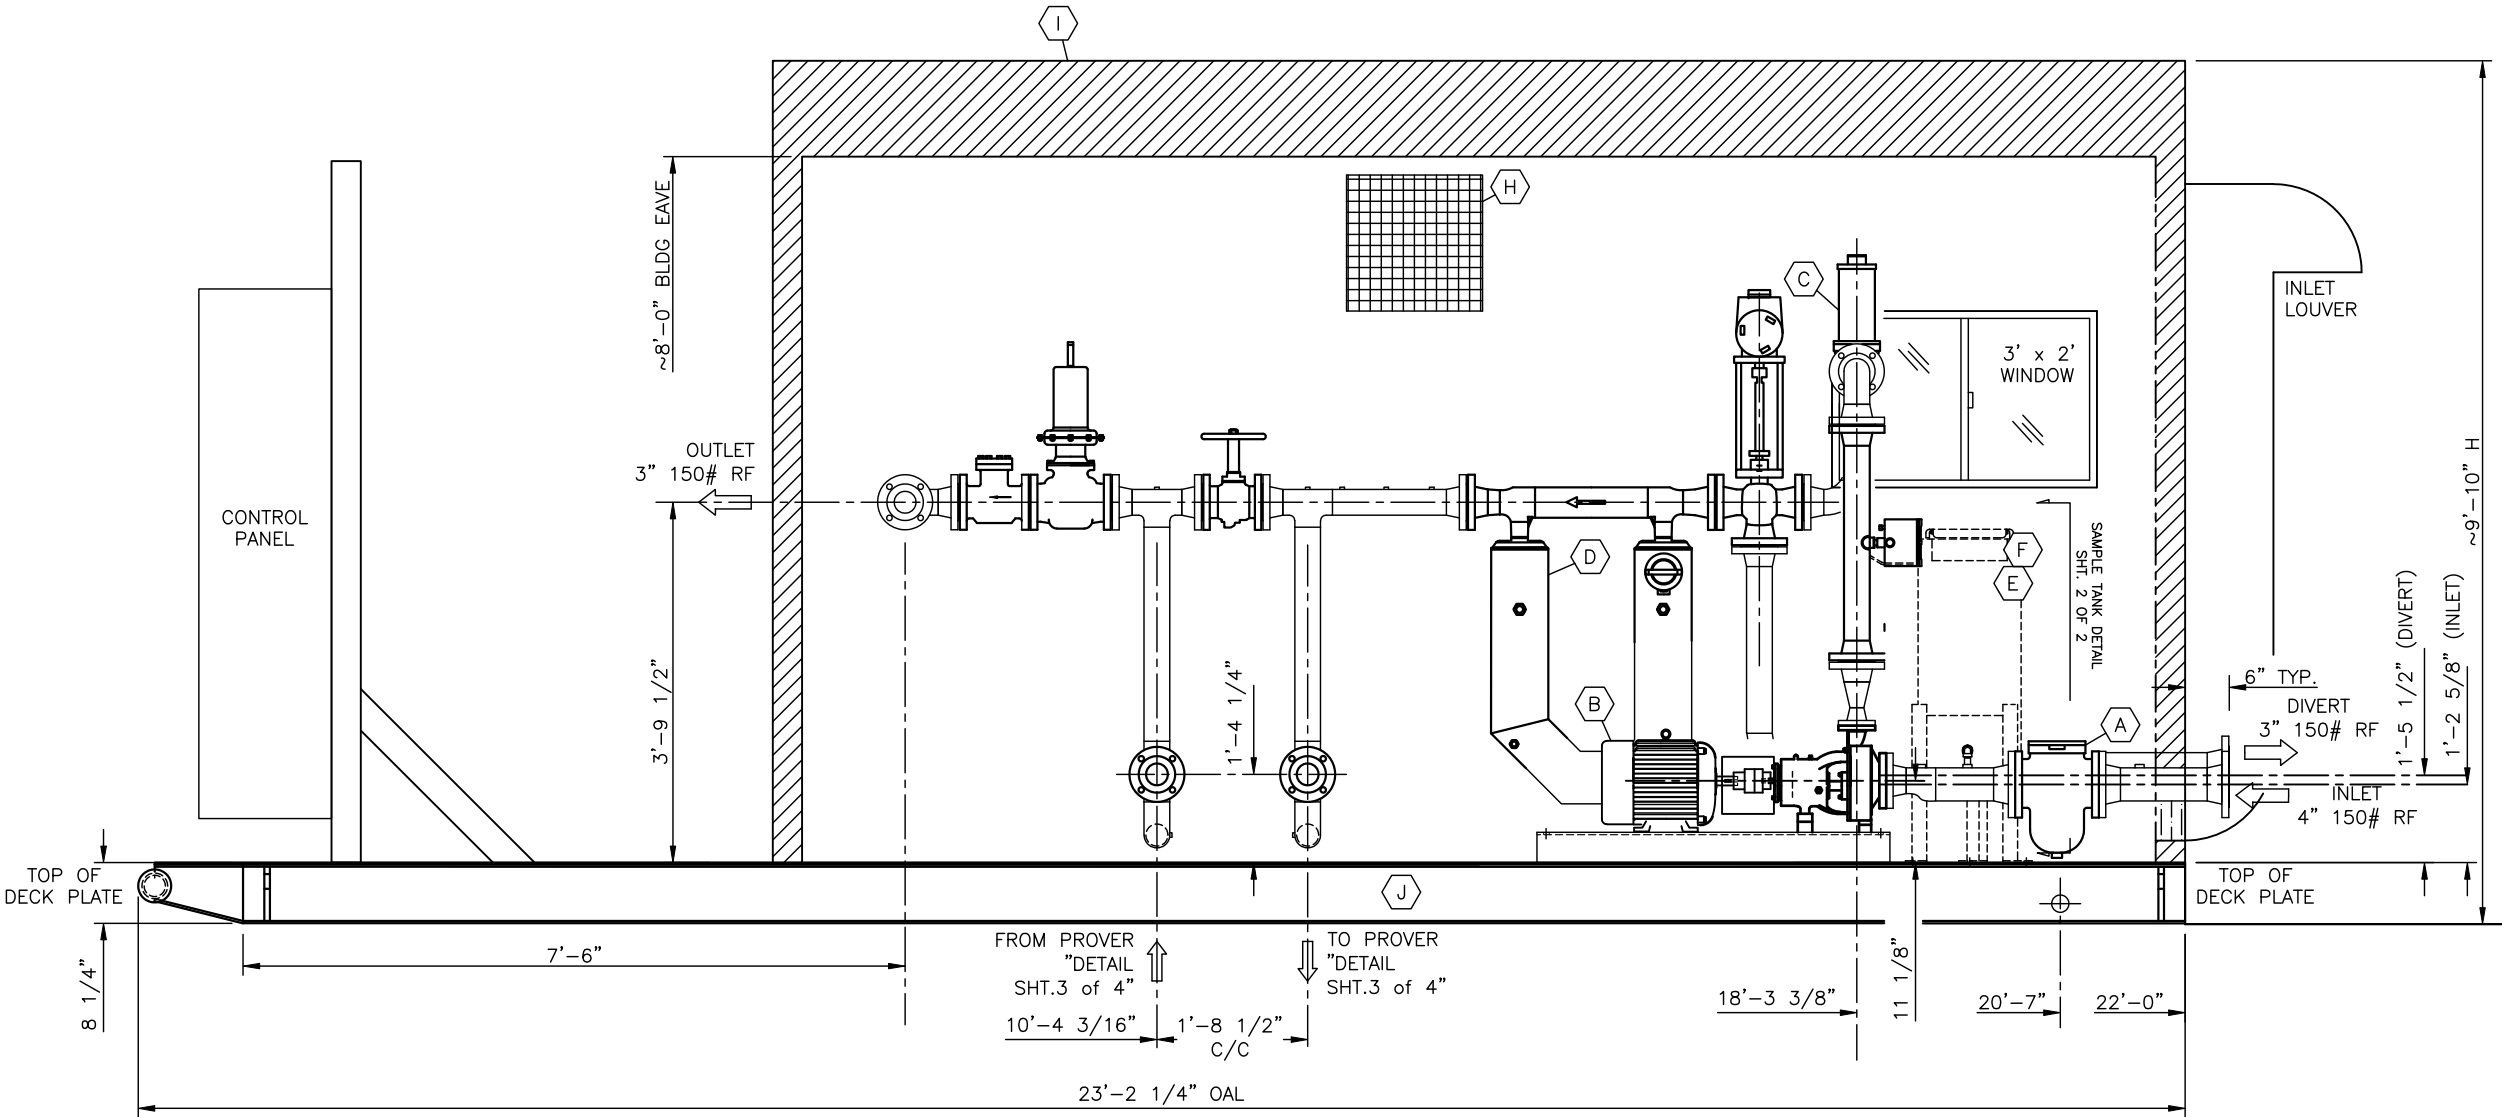

ELEVATION

NOTES:

- REF. SHT.4 "SAMPLE DIAGRAM" FOR PIPING REFERENCE.
- TOTAL PKG. WEIGHT APPROX. 11,500 LBS.
- INTERIOR BUILDING COLOR: WHITE
- EXTERIOR BUILDING, SKID, AND DECKPLATE COLOR: CARLSBAD CANYON TAN
- INSULATION TO BE: R-13 & 2" SPRAY FOAM UNDER SKID.
- S01088858 REDESIGN TO DWG# HSCP-LACT-7 SET OF DRAWINGS: P-1100 & LM-1100 CHANGE & NO DIVERT

NOTICE: This drawing has not been published but rather has been prepared for

by Power Service solely in respect of the construction, operation, and maintenance of the facility named in the title block and shall not be used for any other purpose or furnished to any other party, without the express written consent of Power Service, Inc.

NO.		DATE	BY	DESCRIPTION	CHK'D	APPR.	DWG NO.	TITLE
3	04/15/13	CLC		AS-BUILT	ZR	SK		
2	09/05/12	JS		ADDED 3070 DOOR, LOWERED PROVING LINES	ZR	SK		
1	08/20/12	JS		AS BUILT MARKUPS	ZR	SK		
0	06/18/12	JS		FOR CONSTRUCTION	ZR	SK		
A	05/25/12	JE		FOR APPROVAL	ZR	SK	HSCP-LACT-PID-6	P&ID
REVISIONS					REFERENCE DRAWINGS			

**PS** POWER SERVICE, INC.  
CASPER, WYOMING USA  
(307) 472-7722


THIS DRAWING IS THE PROPERTY OF POWER SERVICE CASPER, WYOMING, USA.	
CUSTOMER	
EQUIPMENT GENERAL ARRANGEMENT	
SWEET CRUDE LACT/LINE PUMP PKG. C.O.S. 80°F, .82 SG, 8,400 BPD @ 45 PSI	
SHEET: 2 OF 4	PROJECT NO. SEE-LOG
DWG. NO. D-HSCP-LACT-LO-6	REV. 3

BILL OF MATERIALS


ITEM	QTY	DESCRIPTION	SPEC.	ITEM	QTY	DESCRIPTION	SPEC.	ITEM	QTY	DESCRIPTION	SPEC.
(1)	1	PL. 11ga., BOX MATERIAL	SA-36	(13)							
(2)	1	EXPANDED METAL SCREEN:	C.S.	(14)							
(3)	1	BOX DRAIN 1/2" FNPT	C.S.	(15)						ITEMS NOT SHOWN	
(4)	2	RB 1/2" X 1'-2" LG, LIFTING HANDLE	SA-36	(16)							
(5)	1	HINGED LID	SA-36	(17)							
(6)				(18)							
(7)				(19)							
(8)				(20)							
(9)				(21)							
(10)				-							
(11)				-							
(12)				-							

SWO # LOG	
SWO#1	1088858 x1
SWO#2	1088873 x8
SWO#3	
SWO#4	
SWO#5	


REVISED	
PREPARED BY:	JS
DATE:	08/20/13
REVISION #	3
APPROVED BY:	ZR
SWO #	SEE LOG

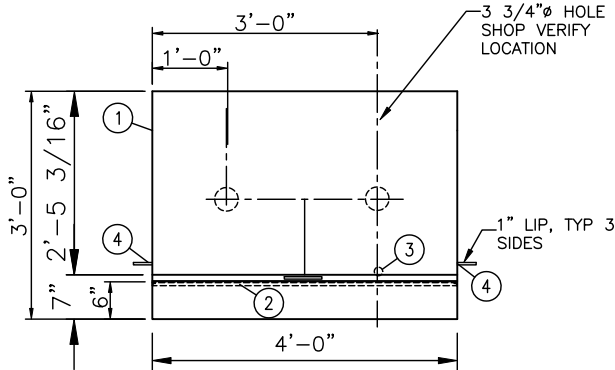


ELEVATION

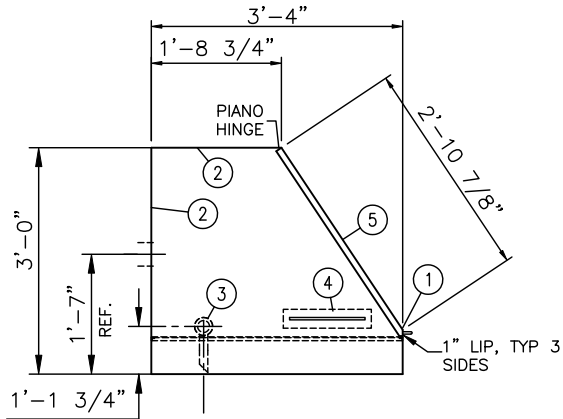


END VIEW

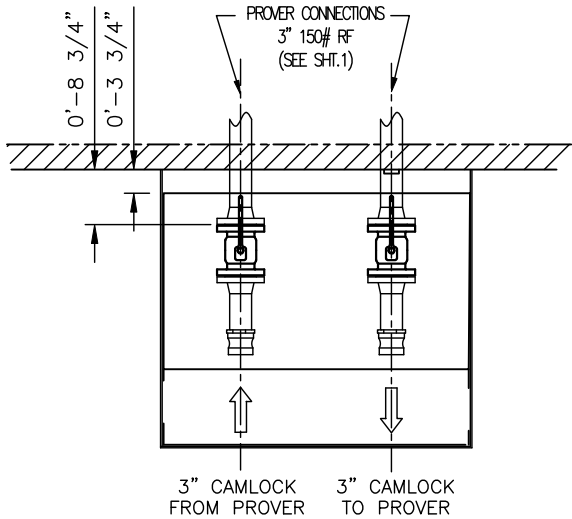


DETAIL A-A

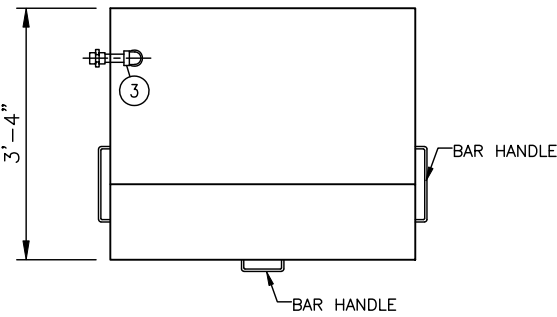

PLAN  
GETTY BOX DETAILS

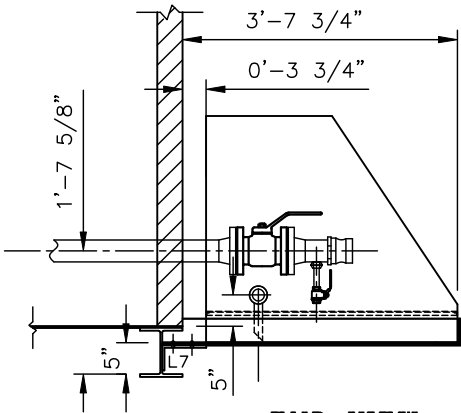

END VIEW

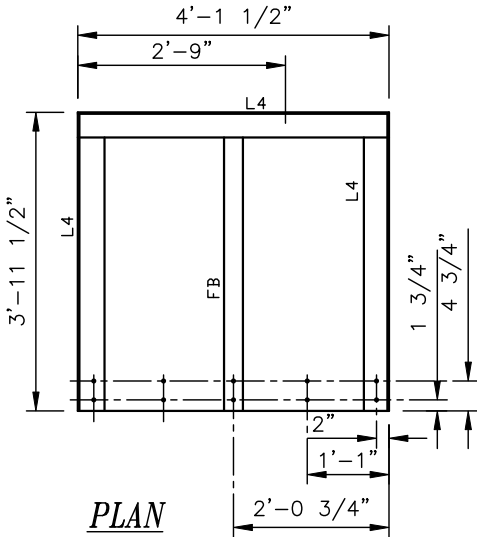

GETTY BOX PLATFORM DETAILS

NOTES:

1. TOTAL GETTY BOX WT APPROX. 350 LBS. PER BOX, 175 LBS. PER PLATFORM.

NOTICE: This drawing has not been published but rather has been prepared for  
by Power Service solely in respect of the construction, operation, and maintenance of the facility named in the title block and shall not be used for any other purpose or furnished to any other party, without the express written consent of Power Service, Inc.

NO.	DATE	BY	DESCRIPTION	CHK'D	APPR.	DWG NO.	TITLE
3	08/20/12	JS	UPDATED DESIGN	ZR	SK		
2	08/15/12	CC	UPDATED LENGTHS PER CUST. REVISIONS	ZR	SK		
1	07/30/12	CC	CHANGED LENGTH TO 4'-0"	ZR	SK		
0	06/18/12	JS	FOR CONSTRUCTION	ZR	SK		
A	05/25/12	JE	FOR APPROVAL	ZR	SK	HSCP-LACT-PID-6	P&ID
REVISIONS				REFERENCE DRAWINGS			

**PS** POWER SERVICE, INC.  
CASPER, WYOMING USA  
(307)472-7722

DWN BY	CHK'D BY	APP'D BY	ENGINEER	DATE DWN	SCALE
JE	ZR	SK	-	05/25/12	N.T.S.

THIS DRAWING IS THE PROPERTY OF POWER SERVICE CASPER, WYOMING, USA.	
CUSTOMER	
EQUIPMENT GENERAL ARRANGEMENT SWEET CRUDE LACT/LINE PUMP PKG. C.O.S. 80°F, .82 SG, 8,400 BPD @ 45 PSI	
SHEET: 3 OF 4	PROJECT NO. SEE-LOG
DWG. NO. D-HSCP-LACT-L0-6	REV. 3

## LEGEND

EQUIPMENT / CONNECTION LIST	MK	TAG	QTY	DESCRIPTION	MFG.	MOD.	CONTROL / VALVE LIST	MK & TAG	QTY	DESCRIPTION	FITTING / PIPE LIST	QTY	SIZE	DESCRIPTION	CLASS/SCH	SPEC/GR.	
	A	V-1000	1	SAMPLE TANK: 14" S/40 x 2'-0" S/S, WELD CAP, AND SEALED TANK LID,	PSI	14-2-VST-30-D			1	BALL VALVE: 1/4" 2000# FNPT		1	1 1/4" NPT x 1" FNPT	REDUCER BUSHING	3000#	SA-105	
					-				5	BALL VALVE: 1/2" 2000# FNPT		1	1" NPT x 1/2" FNPT	REDUCER BUSHING	3000#	SA-105	
	B	P-1000	1	SAMPLE PUMP: 1 1/4" SUCTION, 1" DISCHARGE	FLOWSERVE	SMP-1000			1	BALL VALVE: 1" 2000# FNPT		2	1/2" NPT x 1/4" FNPT	REDUCER BUSHING	3000#	SA-105	
				MOTOR: 1/2 HP, 1800 RPM, 230/1/60, XP	-	-			1	CHECK VALVE: 1/2" 200# FNPT		1	1" FNPT	UNION, THREADED	3000#	SA-105	
								LG-1000	1	LEVEL GAUGE: 5/8" x 20" SIGHT GLASS, 4-BAR PROTECTION, W/ SET VALVES: 1/2" 500# NPT, PENBERTHY MOD. N7A, #64251-030		3	1/2" FNPT	UNION, THREADED	3000#	SA-105	
								PI-1000	1	PRESSURE INDICATOR: 1/4" NPT x 2.5", 0-15, W/ 1/4" NPT x FNPT 6000# NEEDLE VALVE		3	1" FNPT	ELBOW 90°, THREADED	3000#	SA-105	
				CONNECTION SCHEDULE								5	1/2" FNPT	ELBOW 90°, THREADED	3000#	SA-105	
	C1		1	DRAIN: 1" 3000# HALF CPLG					1	VACUUM BREAKER: 1/4" NPT, STEEL PETCOCK, 1/4 TURN TYPE		2	1/2" FNPT	TEE, THREADED	3000#	SA-105	
	C2		1	INLET-CIRCULATING: 1/2" 3000# FULL CPLG								1	1/4" FNPT	CROSS, THREADED	3000#	SA-105	
	C3		1	PSV: 1/2" 3000# HALF CPLG				PSV-1000	1	PRESSURE RELIEF VALVE: 1/4" FNPT, FISHER #289A		4	1/4" x 2" LG.	PIPE NIPPLE	S/80	SA-106B	
	C4		1	INLET-SAMPLE: 1/2" 3000# HALF CPLG								9	1/2" x 2" LG.	PIPE NIPPLE	S/80	SA-106B	
	C5A,B	LG-1000	2	LEVEL GAUGE UPPER/LOWER: 1/2" 3000# HALF COUPLING								2	1" x 2" LG.	PIPE NIPPLE	S/80	SA-106B	
												1	1/2" NPT x 1/2" T	ELBOW 90°, SWAGELOK#SS-810-2-8 (MAN. SAMPLE BV)			
												1	1/4" NPT x 1/4" T	ELBOW 90°, SWAGELOK#SS-400-2-4 (FCV-101 CONNECTION)			
												1	1/2" NPT x 1/2" T	MALE ADAPTER, SWAGELOK#SS-810-1-8 (C2 CONNECTION)			
												1	1/2" T	TEE, SWAGELOK#SS-810-3 (C2 CONNECTION)			
												4'	1"	PIPE	S/80	SA-106B	
												6'	1/2"	PIPE	S/80	SA-106B	

FOR CONSTRUCTION

DATE: 06/25/12

APPROVED BY: SK



---

SWO	#	LOG
1	1	1
2	2	2
3	3	3
100	100	100

SWO#2 1088873 x8

SWO#4

SWO#5

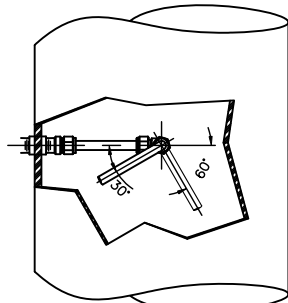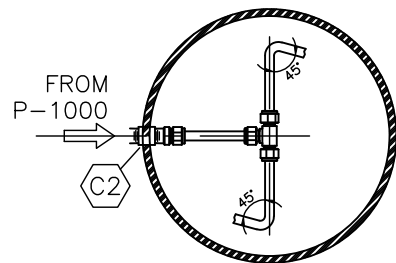

INTERNAL VIEW OF  
CONNECTION C2

1.

THIS DRAWING IS THE PROPERTY OF POWER SERVICE  
CASPER, WYOMING, USA.


O	06/18/12	JS	FOR CONSTRUCTION	ZR	SK	14-2-VST-30-D	VESSEL FAB. DRAWING
A	05/25/12	JE	FOR APPROVAL	ZR	SK	HSCP-LACT-PID-6	P&ID
NO.	DATE	BY	DESCRIPTION	CHK'D	APPR.	DWG NO.	TITLE
REVISIONS						REFERENCE DRAWINGS	



CUSTOMER \_\_\_\_\_

15 GAL. SAMPLE SYSTEM DETAIL  
3" LACT PACKAGE

by Power Service solely in respect of the construction, operation, and maintenance of the facility named in the title block and shall not be used for any other purpose or furnished to any other party, without the express written consent of Power Service, Inc.

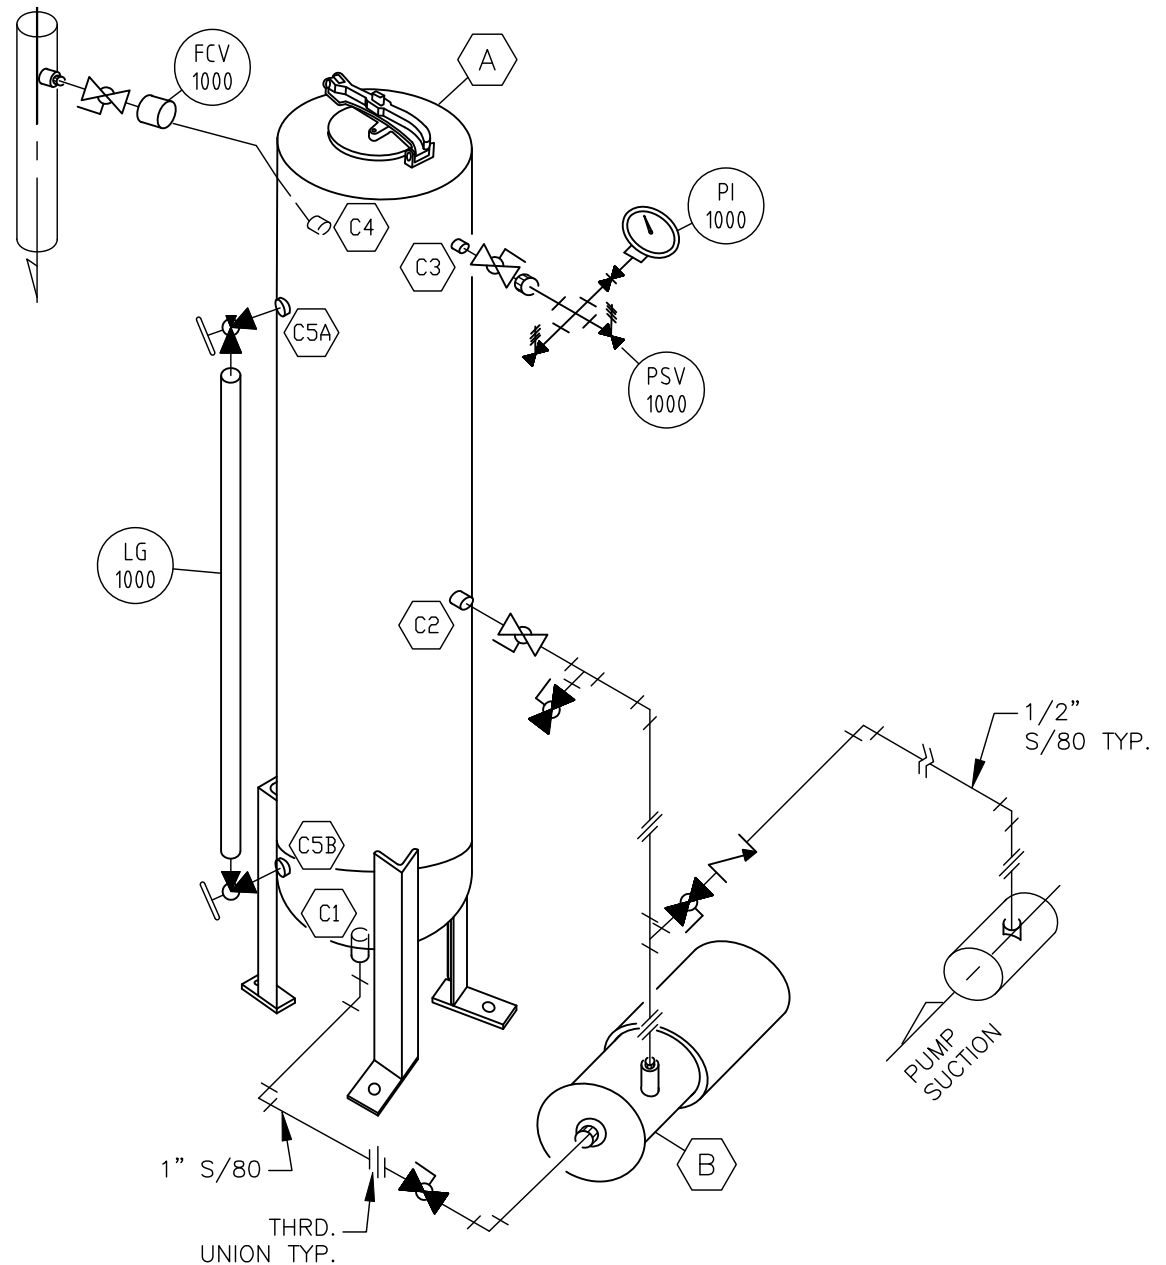

PIPING DIAGRAM -PIPING TO BE FITTED IN SHOP